

KEY

- PROPOSED
- NO WAITING AT ANY TIME
- REVOCATION OF EXISTING WAITING, LOADING AND PARKING RESTRICTIONS (NOT VISIBLE IF UNDER PROPOSALS)
- EXISTING WAITING, LOADING AND PARKING RESTRICTIONS (WITH OR WITHOUT SYMBOLS)

NOTES

Rev.	Description	Drawn	Sp.	Date	Chk'd	Sp.	Date	Appr.	Sp.	Date
A	WAITING RESTRICTIONS AMENDED	500	500	09/07/09	500	500	09/07/09	TPC	TPC	09/07/09
B	RESTRICTIONS AMENDED	500	500	06/13	500	500	06/13	AM	AM	06/13
C	RESTRICTIONS AMENDED	500	500	06/13	500	500	06/13	AM	AM	06/13

Scale: 1:150


Project No: 3287/WOK
 Client: Woking Council
 Drawing No: 20007
 Revision: C
 Date: 06/13/09

BYFLEET DPE WOKING IMPLEMENTED TRAFFIC ORDERS

Checked by: [Signature] Date: 05/05/09
 Approved by: [Signature] Date: 05/05/09

Project: Sustainable Development
 Drawing: 20007
 Revision: C
 Date: 06/13/09

SHEET 7 of 101

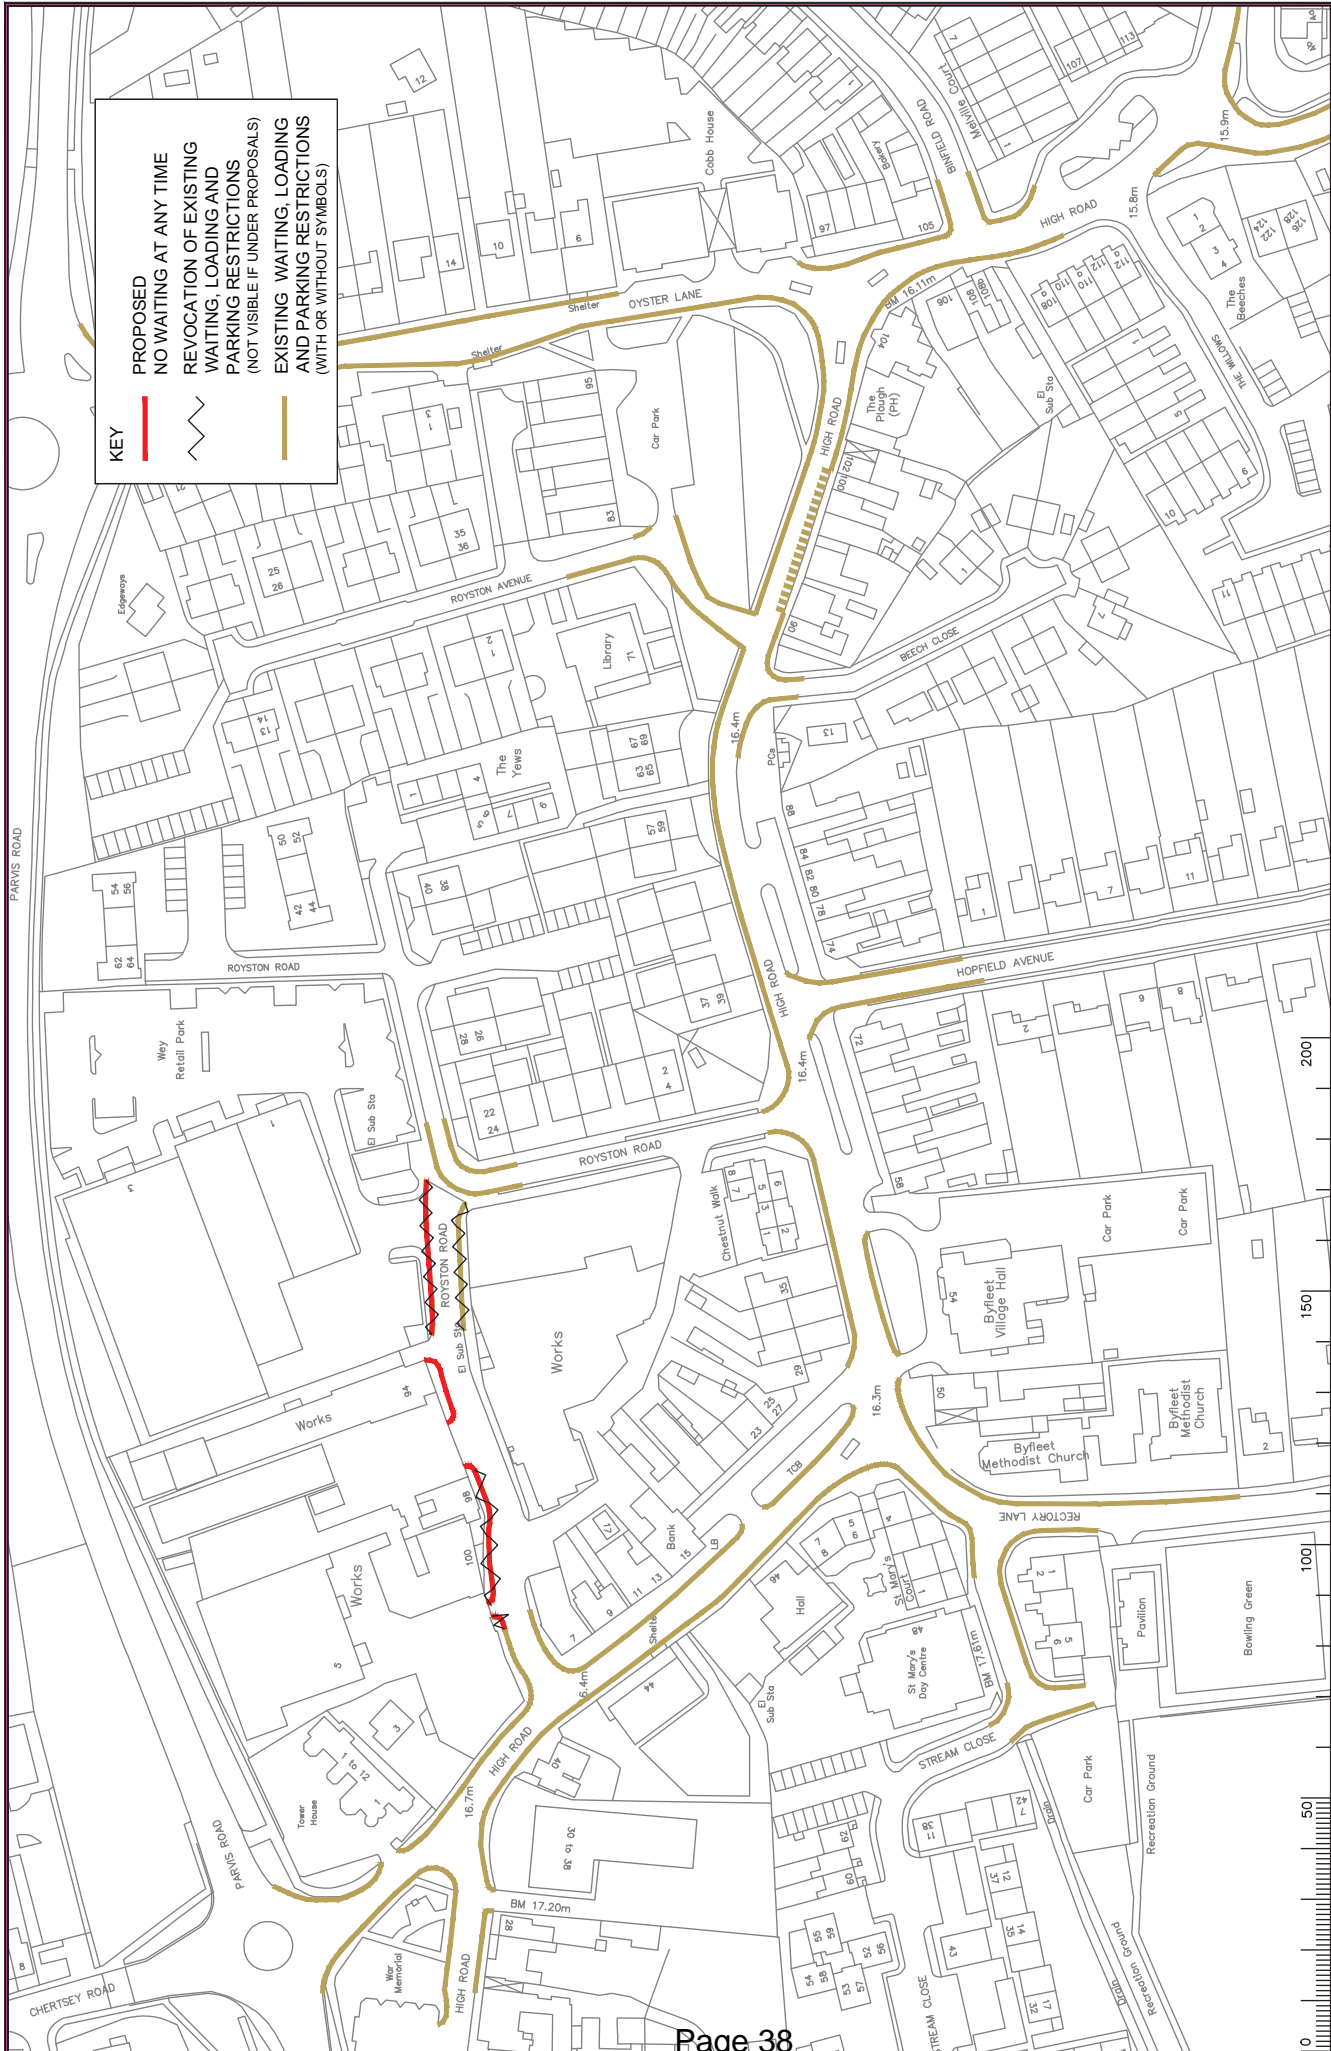

KEY

- PROPOSED NO WAITING AT ANY TIME
- REVOCATION OF EXISTING WAITING, LOADING AND PARKING RESTRICTIONS (NOT VISIBLE IF UNDER PROPOSALS)
- EXISTING WAITING, LOADING AND PARKING RESTRICTIONS (WITH OR WITHOUT SYMBOLS)

NOTES

Rev.	Description	Drawn	Sp.	Date	Appr.	Sp.	Date
A	WAITING RESTRICTIONS AND LINE TYPES AMENDED	AM	AM	12/12/07	SP	SP	12/12/07
B	RESTRICTIONS AMENDED	CAH	CAH	23/12/08	SP	SP	23/12/08
C	RESTRICTIONS AMENDED	CAH	CAH	05/14	SP	SP	05/14
D	RESTRICTIONS AMENDED	CAH	CAH	05/14	SP	SP	05/14

Project: S:\Project-current\3282\WOK_VAD-Drawing\18_2014\3282-2009_P.dwg Scale: 1:150

North

Checked by	Date	Checked by	Date
SP	05/15	AM	05/15
SP	05/15	TPC	05/15


Approved by: TPC Date: 05/15

Project: 3282/WOK
 Drawing: 2009
 Date: 05/15
 Scale: 1:150

BYFLEET DPE WOKING
IMPLEMENTED TRAFFIC ORDERS

SHEET 2 of 101


PROPOSAL

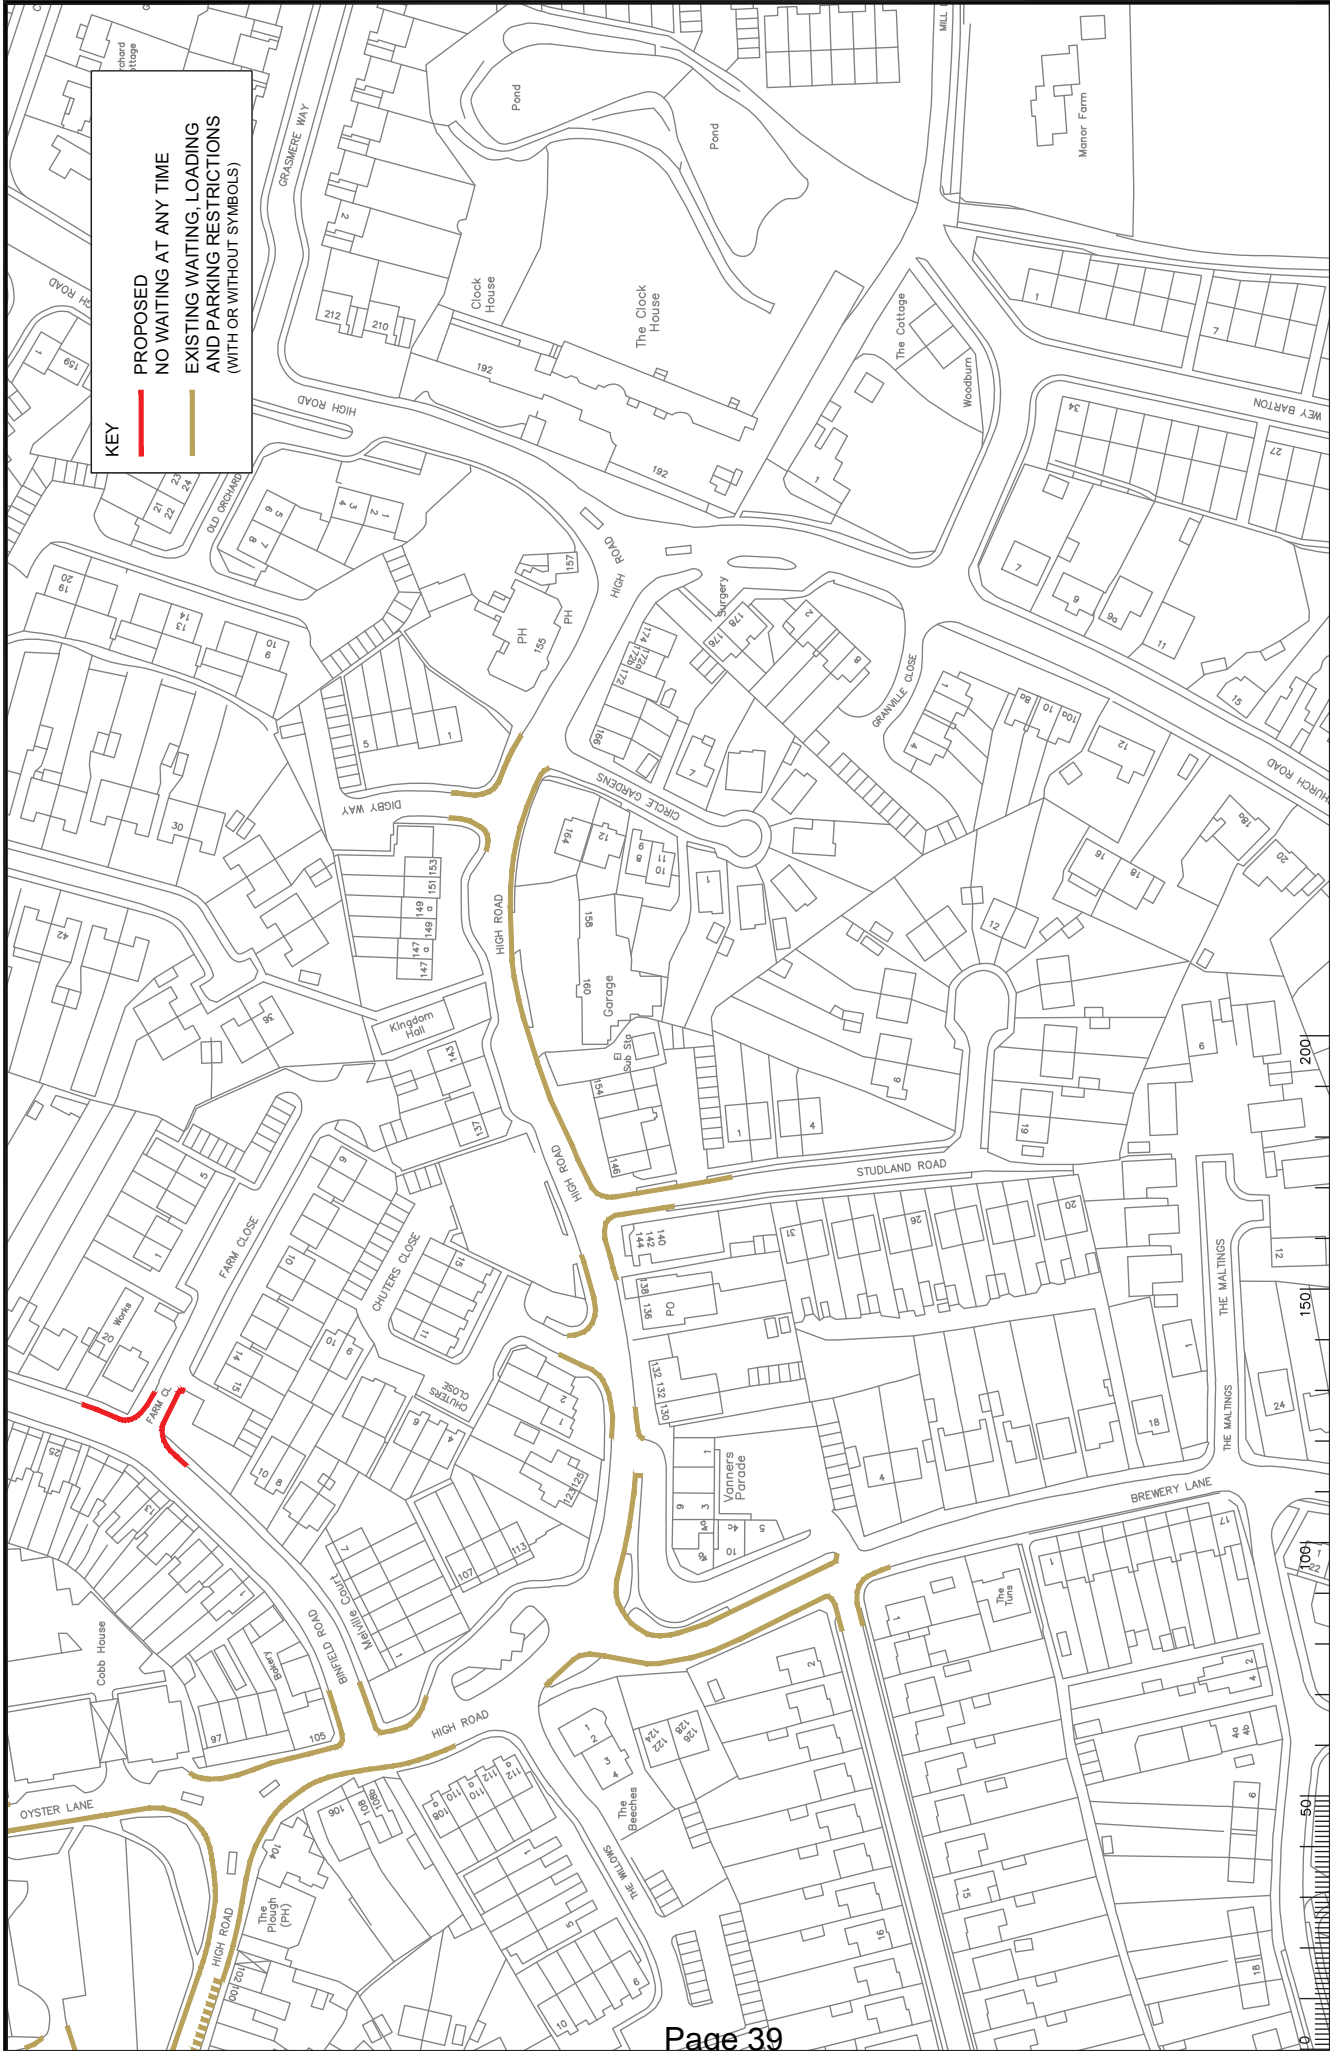

<p>SURREY COUNTY COUNCIL Sustainable Development</p>	<p>Project No: 3282WOK</p> <p>Contract No: 20010</p> <p>Drawn By: [Name]</p> <p>Date: [Date]</p>	<p>Project: BYFLEET DPE WOKING</p> <p>Implemented Traffic Orders</p>	<p>Scale: 1:1500</p>
	<p>Approved by: [Name]</p> <p>Date: [Date]</p>	<p>Checked by: [Name]</p> <p>Date: [Date]</p>	<p>Drawn: [Name]</p> <p>Date: [Date]</p>
	<p>Project No: 3282WOK</p> <p>Contract No: 20010</p> <p>Drawn By: [Name]</p> <p>Date: [Date]</p>	<p>Project: BYFLEET DPE WOKING</p> <p>Implemented Traffic Orders</p>	<p>Scale: 1:1500</p>

KEY

- PROPOSED NO WAITING AT ANY TIME
- REVOCAION OF EXISTING WAITING, LOADING AND PARKING RESTRICTIONS (NOT VISIBLE IF UNDER PROPOSALS)
- EXISTING WAITING, LOADING AND PARKING RESTRICTIONS (WITH OR WITHOUT SYMBOLS)

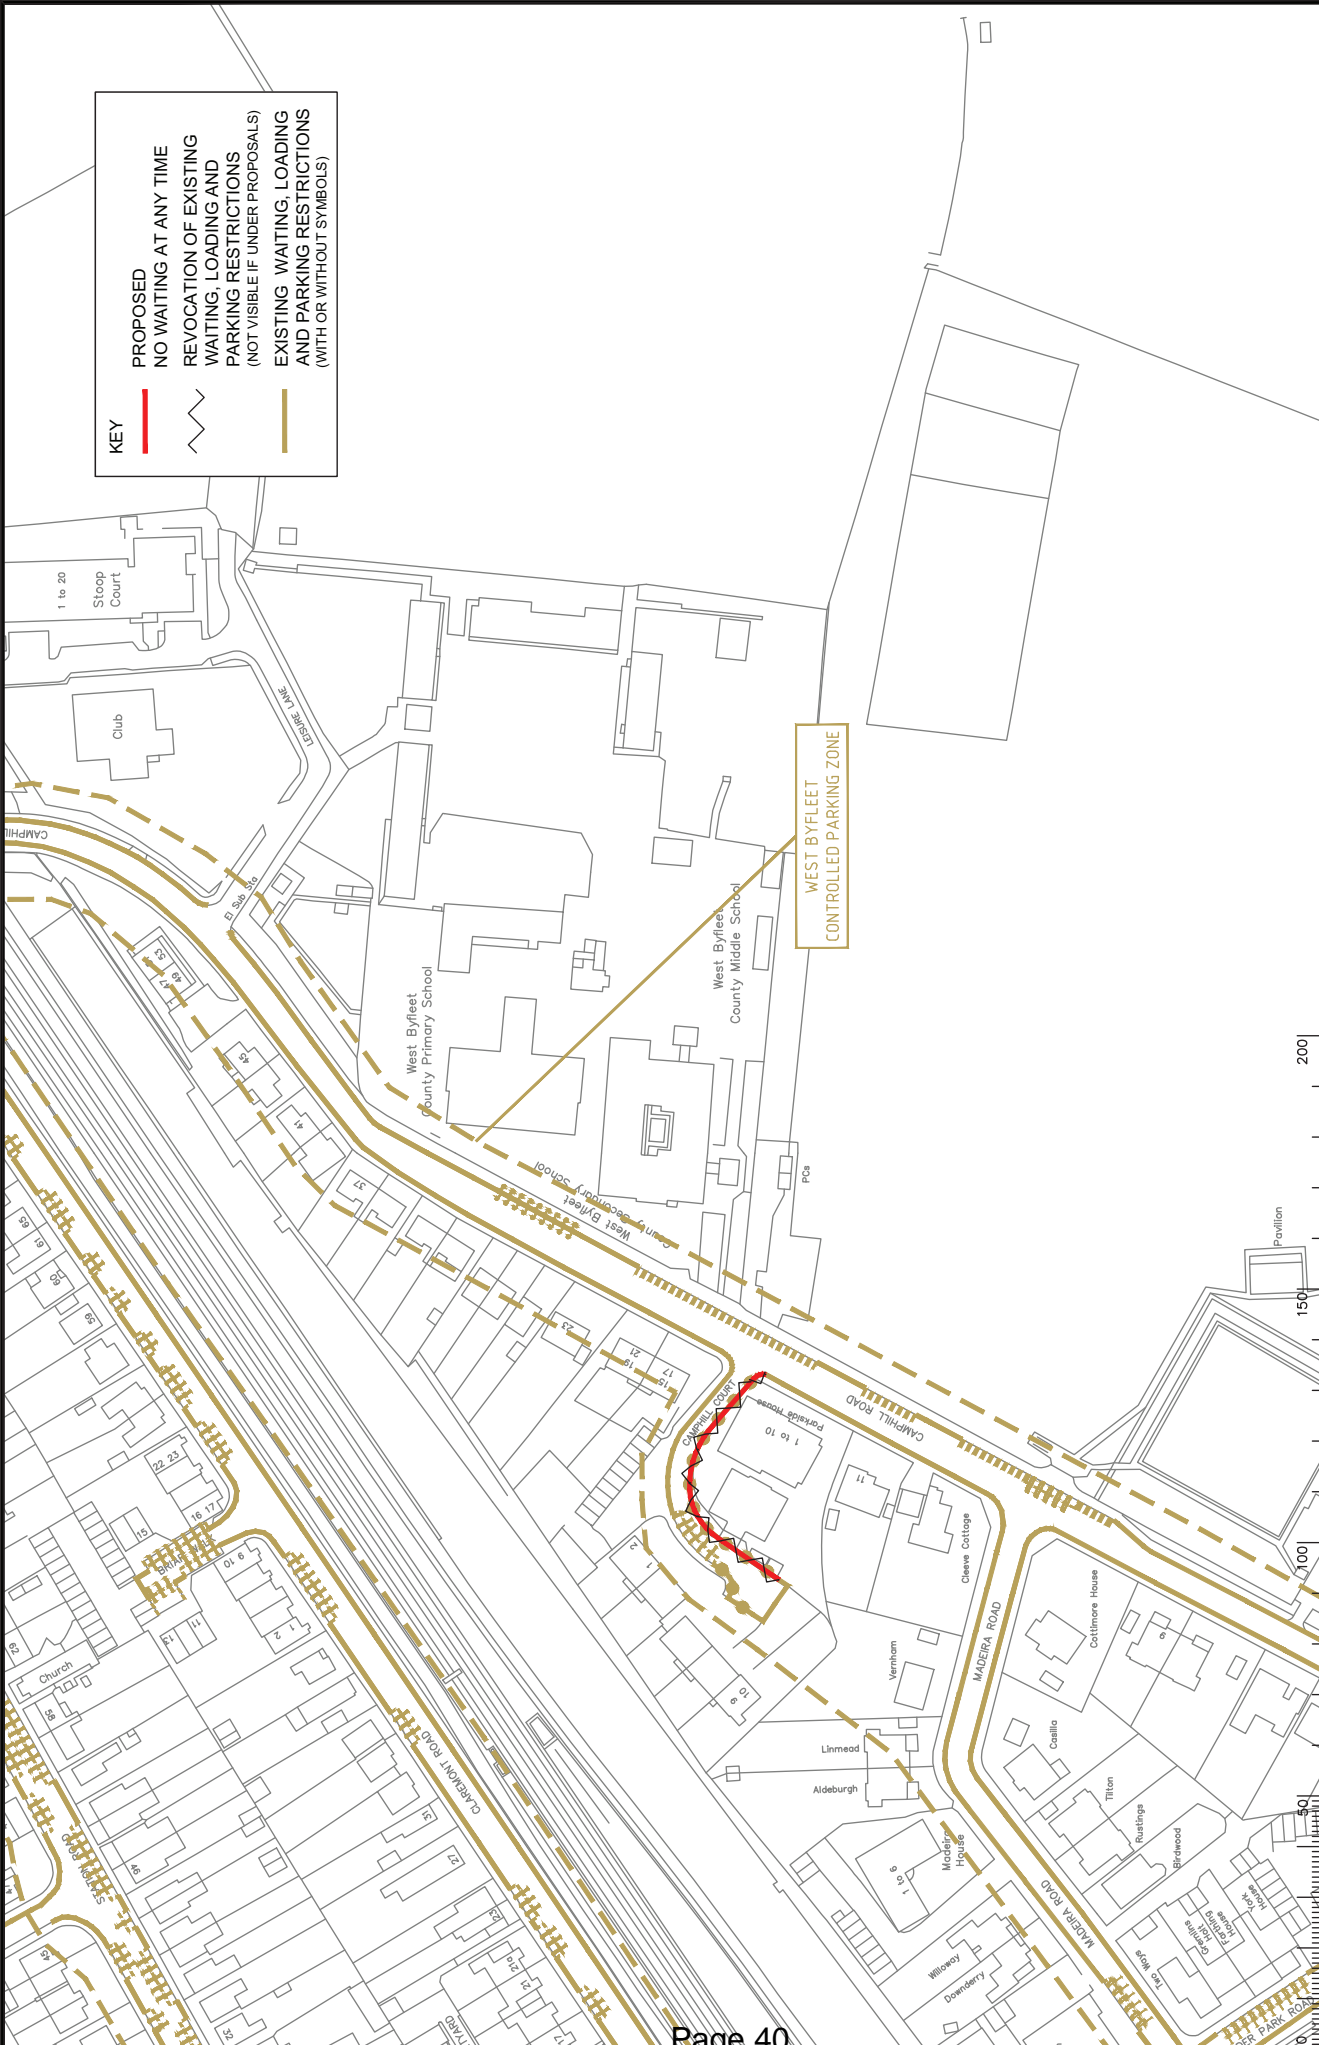

WEST BYFLEET DPE WORKING IMPLEMENTED TRAFFIC ORDERS

Project No. 3287/WOK
 Surrey County Council
 Sustainable Development
 Approved by the Council on 15/05/15

West Byfleet Controlled Parking Zone


Project No. 3287/WOK
 Surrey County Council
 Sustainable Development
 Approved by the Council on 15/05/15

West Byfleet DPE WORKING IMPLEMENTED TRAFFIC ORDERS


Project No. 3287/WOK
 Surrey County Council
 Sustainable Development
 Approved by the Council on 15/05/15

Rev.	Description	Drawn	Sig.	Date	Checked	Sig.	Date	Appr.	Sig.	Date
A	WAITING RESTRICTIONS AND LINEWORKS AMENDED	AM	AM	18/12/07	SP	SP	18/12/07	TRC	TRC	18/12/07
B	RESTRICTIONS AMENDED	CH	CH	05/13	AM	AM	05/13	TRC	TRC	05/13
C	RESTRICTIONS AMENDED	CH	CH	05/14	AM	AM	05/14	TRC	TRC	05/14
D	RESTRICTIONS AMENDED	CH	CH	05/14	AM	AM	05/14	TRC	TRC	05/14

S:\Project-current\3287\WOK\CAD-Drawing\15-ADVERTISED_V3-2014\3287-20046_D.dwg

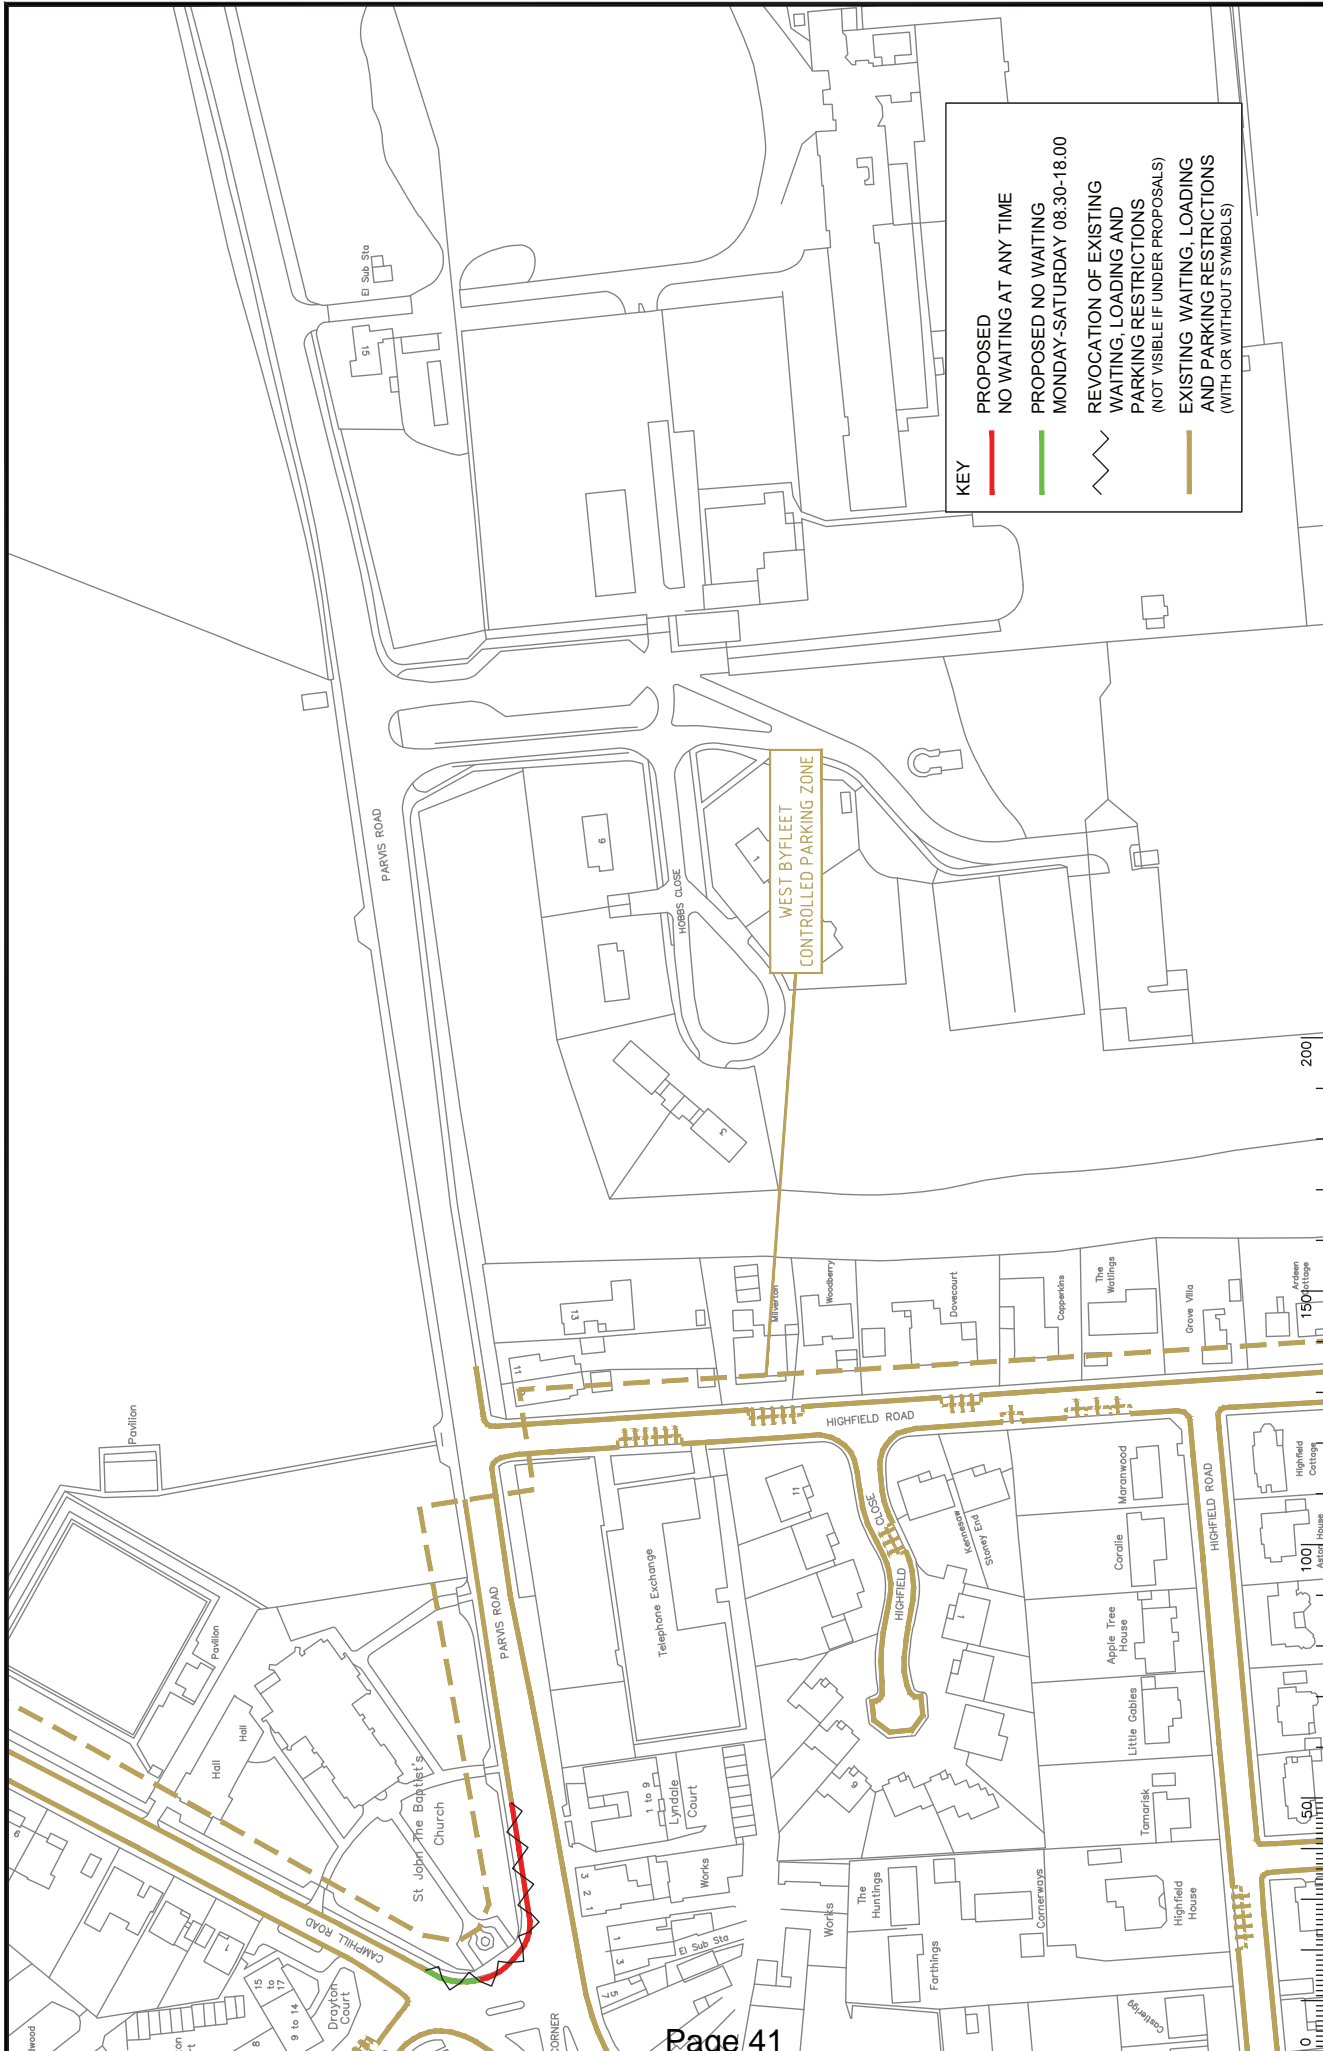


<p>SURREY COUNTY COUNCIL Sustainable Development Member of the Local Authority</p>		<p>Project No. 3287/WOK</p> <p>Contract No. 20049</p> <p>Rev. C</p> <p>Document No. PROPOSAL</p>																																
<p>WEST BYFLEET DPE WORKING</p>		<p>Project Name: West Byfleet DPE Working</p> <p>Location: West Byfleet, Surrey</p> <p>Client: Surrey County Council</p> <p>Contract No: 20049</p> <p>Rev: C</p> <p>Document No: PROPOSAL</p>																																
<p>IMPLEMENTED TRAFFIC ORDERS</p>		<p>Approved by: [Signature]</p> <p>Date: 15/05/2014</p> <p>Checked by: [Signature]</p> <p>Date: 15/05/2014</p> <p>Approved by: [Signature]</p> <p>Date: 15/05/2014</p>																																
<p>North West</p>		<p>Scale: 1:1250</p>																																
<p>Rev. Description</p> <p>A. Change to Highfield Road</p> <p>B. Change to Highfield Road</p> <p>C. Change to Highfield Road</p>	<p>Drawn: [Name]</p> <p>Sp. [Name]</p> <p>SEC [Name]</p> <p>CHK [Name]</p> <p>DATE [Date]</p>	<table border="1"> <thead> <tr> <th>Date</th> <th>Sp.</th> <th>SEC</th> <th>CHK</th> <th>Date</th> <th>Sp.</th> <th>SEC</th> <th>CHK</th> </tr> </thead> <tbody> <tr> <td>15/05/2014</td> <td>[Name]</td> <td>[Name]</td> <td>[Name]</td> <td>15/05/2014</td> <td>[Name]</td> <td>[Name]</td> <td>[Name]</td> </tr> <tr> <td>15/05/2014</td> <td>[Name]</td> <td>[Name]</td> <td>[Name]</td> <td>15/05/2014</td> <td>[Name]</td> <td>[Name]</td> <td>[Name]</td> </tr> <tr> <td>15/05/2014</td> <td>[Name]</td> <td>[Name]</td> <td>[Name]</td> <td>15/05/2014</td> <td>[Name]</td> <td>[Name]</td> <td>[Name]</td> </tr> </tbody> </table>	Date	Sp.	SEC	CHK	Date	Sp.	SEC	CHK	15/05/2014	[Name]	[Name]	[Name]	15/05/2014	[Name]	[Name]	[Name]	15/05/2014	[Name]	[Name]	[Name]	15/05/2014	[Name]	[Name]	[Name]	15/05/2014	[Name]	[Name]	[Name]	15/05/2014	[Name]	[Name]	[Name]
Date	Sp.	SEC	CHK	Date	Sp.	SEC	CHK																											
15/05/2014	[Name]	[Name]	[Name]	15/05/2014	[Name]	[Name]	[Name]																											
15/05/2014	[Name]	[Name]	[Name]	15/05/2014	[Name]	[Name]	[Name]																											
15/05/2014	[Name]	[Name]	[Name]	15/05/2014	[Name]	[Name]	[Name]																											

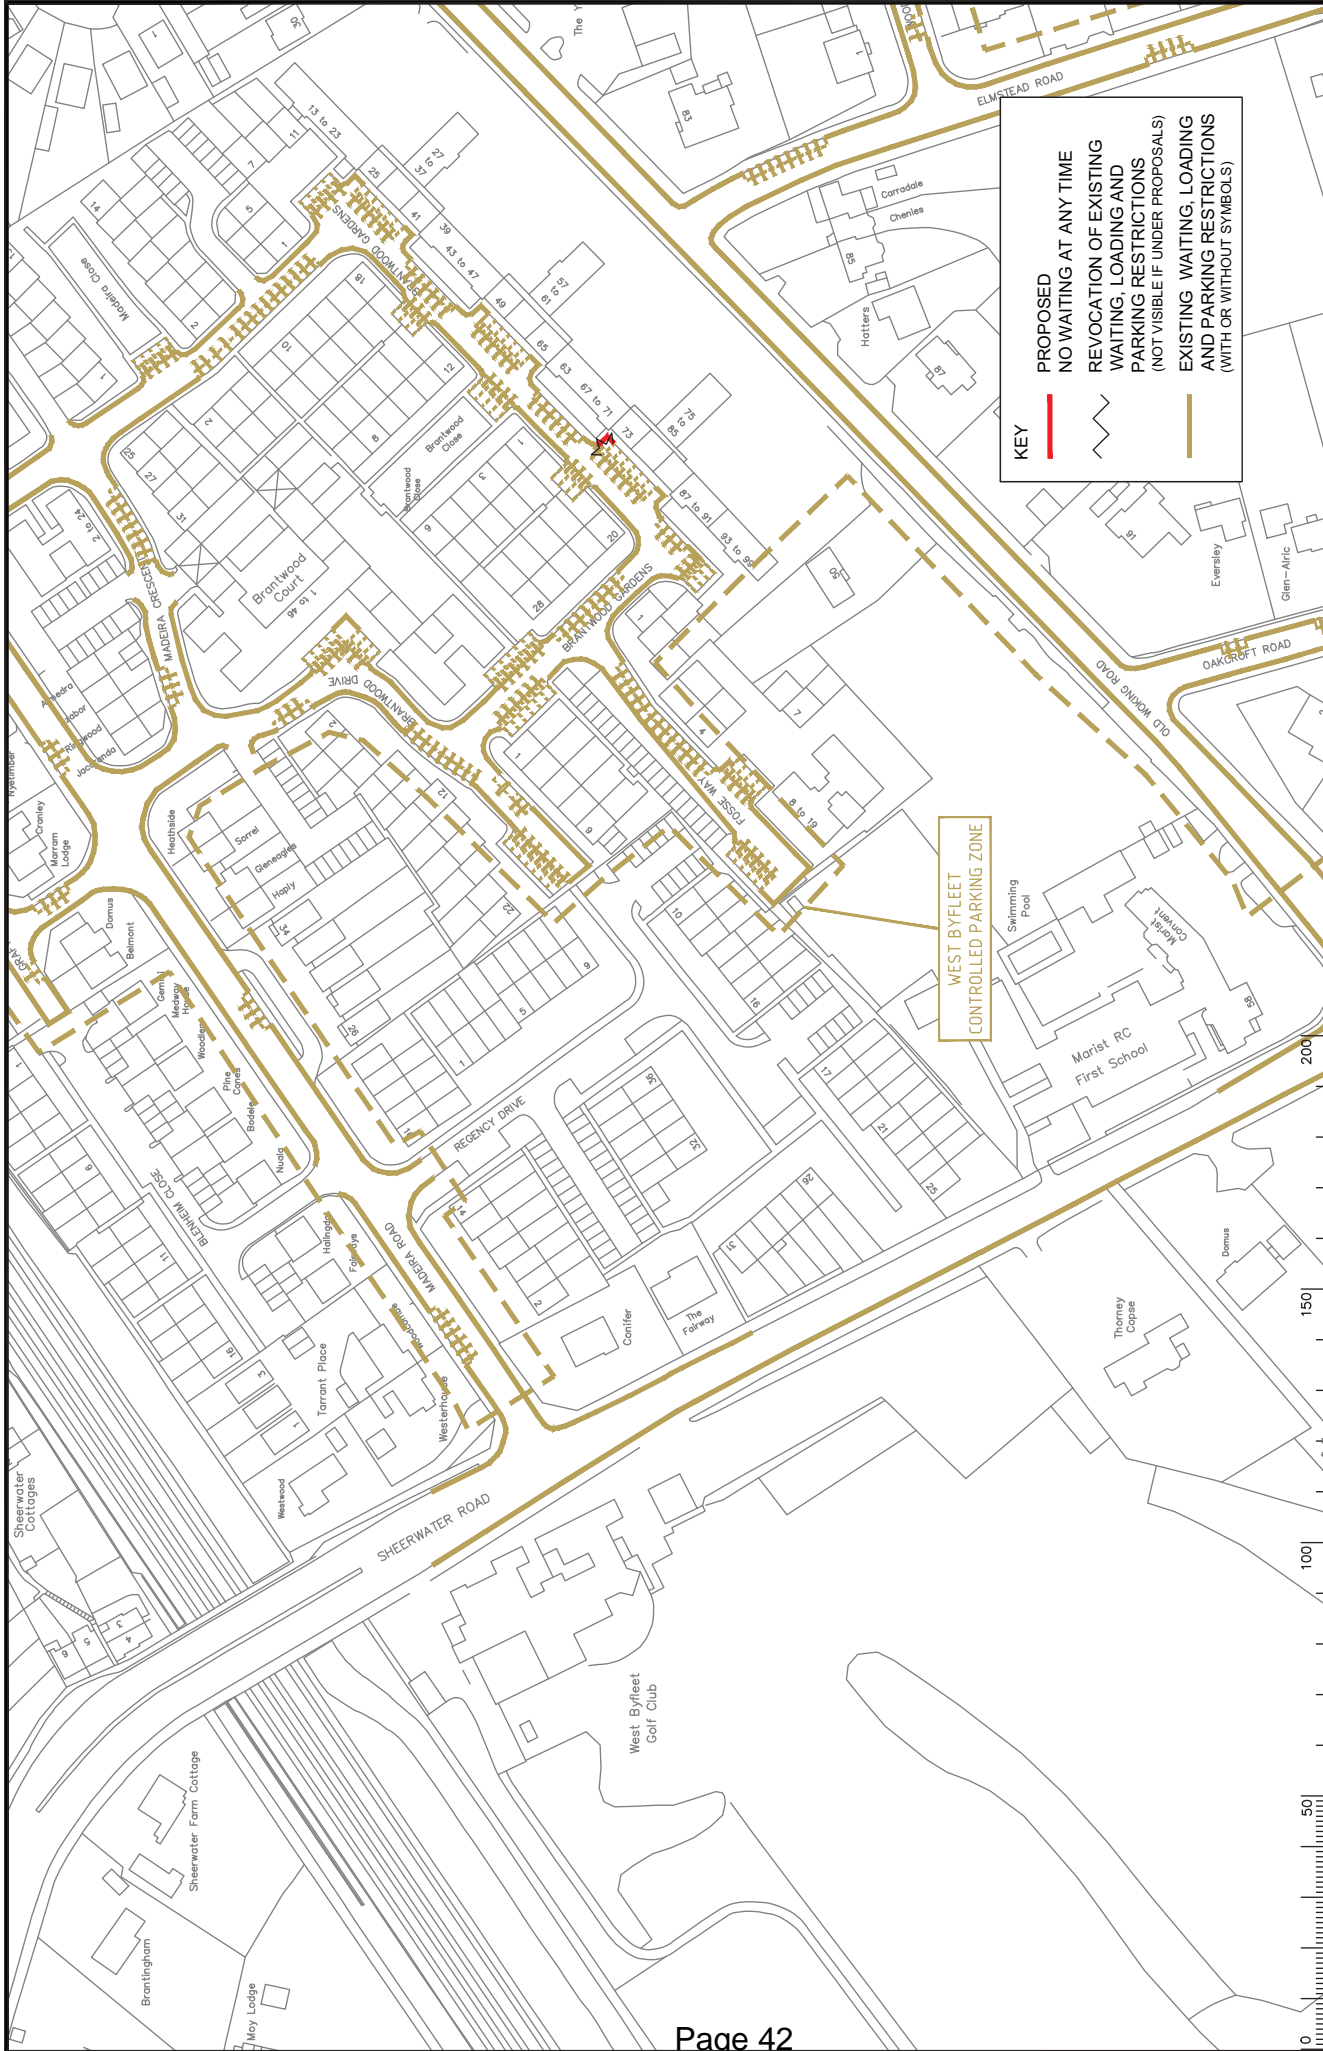

Project No. 3287/WOK		Surrey County Council		Surrey Sustainable Development			
Drawing No. 20052		Revision No. D		Proposal			
Project Name: WEST BYFLEET DPE WORKING		Drawing Title: IMPLEMENTED TRAFFIC ORDERS		SHEET 52a			
Issued by: [Name] Date: 05/05 Checked by: [Name] Date: 05/05 Approved by: [Name] Date: 05/05		Drawn by: [Name] Date: 05/05 Checked by: [Name] Date: 05/05 Approved by: [Name] Date: 05/05		Scale: 1:150			
Rev.	Description	Date	Chk'd	Sig.	Date	Chk'd	Sig.
A	RESTRICTIONS AMENDED	07/11	TC	TC	07/11		
B	RESTRICTIONS AMENDED	05/13	TC	TC	05/13		
C	RESTRICTIONS AMENDED	05/14	TC	TC	05/14		
D	RESTRICTIONS AMENDED	05/14	TC	TC	05/14		

KEY

- PROPOSED NO WAITING AT ANY TIME
- PROPOSED PARKING MONDAY-FRIDAY 08.30-18.00, PAY AT MACHINE, MAX STAY 4 HRS (EXCL. PUBLIC HOLIDAYS) AND SATURDAY 08.30-18.00 FREE PARKING, MAX STAY 4 HRS, NO RETURN WITHIN 1HR (EXCL. PUBLIC HOLIDAYS)
- REVOCAION OF EXISTING WAITING, LOADING AND PARKING RESTRICTIONS (NOT VISIBLE IF UNDER PROPOSALS)
- EXISTING WAITING, LOADING AND PARKING RESTRICTIONS (WITH OR WITHOUT SYMBOLS)

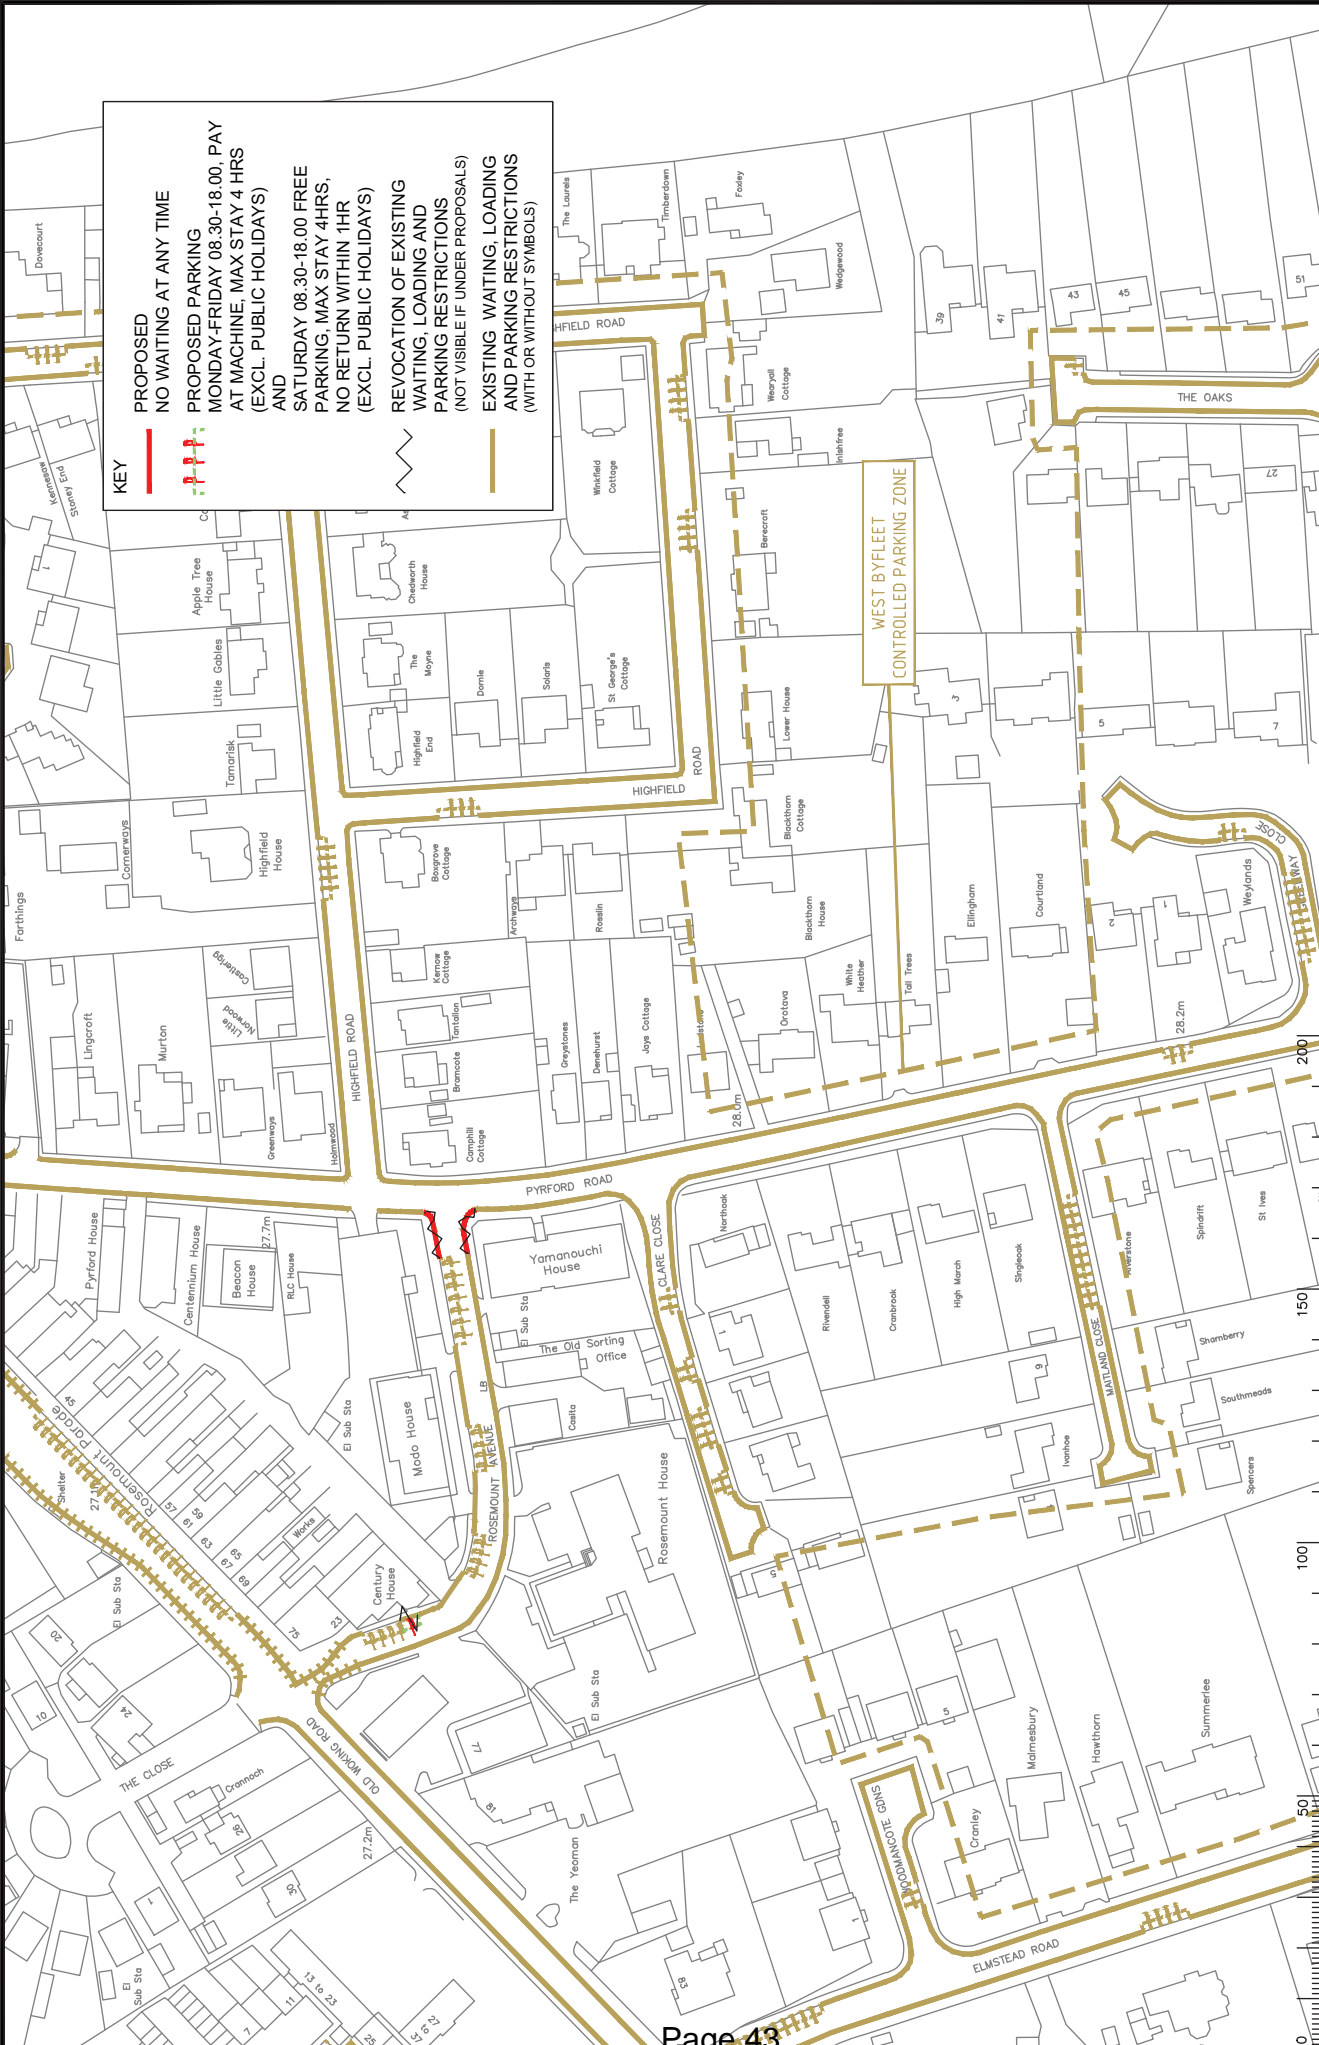

Project No. 3287/WOK

Client Surrey County Council

Project Name WEST BYFLEET DPE WOKING

Drawn By [Name]

Checked By [Name]

Date 12/12/20

Scale 1:150

Revision

Rev.	Description	Drawn	Sp.	Date	Checked	Sp.	Date	Appr.	Sp.	Date
A	Changes to Rosemount Avenue, Highfield Road	SEC	SEC	12/12/20	SEC	SEC	12/12/20	SEC	SEC	12/12/20
B	REVISIONS	SEC	SEC	12/12/20	SEC	SEC	12/12/20	SEC	SEC	12/12/20
C	REVISIONS	SEC	SEC	12/12/20	SEC	SEC	12/12/20	SEC	SEC	12/12/20

WEST BYFLEET DPE WOKING

IMPLEMENTED TRAFFIC ORDERS

Project No. 3287/WOK

Client: Surrey County Council

Project Name: WEST BYFLEET DPE WOKING

Drawn By: [Name]

Checked By: [Name]

Date: 12/12/20

Scale: 1:150

Project No. 3287/WOK

Client: Surrey County Council

Project Name: WEST BYFLEET DPE WOKING

Drawn By: [Name]

Checked By: [Name]

Date: 12/12/20

Scale: 1:150

KEY

- PROPOSED NO WAITING AT ANY TIME
- EXISTING WAITING, LOADING AND PARKING RESTRICTIONS (WITH OR WITHOUT SYMBOLS)



WEST BYFLEET CONTROLLED PARKING ZONE

PROJECT No. 3282/WOK
 Contract No. 20055
 Drawing No. B
 Date 15/05
 Scale 1:1250
 SHEET 55 OF 101

**WEST BYFLEET DPE
 WORKING
 IMPLEMENTED TRAFFIC ORDERS**

Based upon the Ordnance Survey mapping with the following amendments:
 1. The proposed works are shown in yellow.
 2. The proposed works are shown in red.
 3. The proposed works are shown in blue.
 4. The proposed works are shown in green.
 5. The proposed works are shown in purple.
 6. The proposed works are shown in brown.
 7. The proposed works are shown in pink.
 8. The proposed works are shown in grey.
 9. The proposed works are shown in white.
 10. The proposed works are shown in black.

Order No.	Date	Start	End	By	Approved
1	15/05	08:00	18:00	AM	15/05
2	15/05	08:00	18:00	PM	15/05
3	15/05	08:00	18:00	AM	15/05
4	15/05	08:00	18:00	PM	15/05

Order No.	Date	Start	End	By	Approved
5	15/05	08:00	18:00	AM	15/05
6	15/05	08:00	18:00	PM	15/05
7	15/05	08:00	18:00	AM	15/05
8	15/05	08:00	18:00	PM	15/05

Order No.	Date	Start	End	By	Approved
9	15/05	08:00	18:00	AM	15/05
10	15/05	08:00	18:00	PM	15/05
11	15/05	08:00	18:00	AM	15/05
12	15/05	08:00	18:00	PM	15/05

Order No.	Date	Start	End	By	Approved
13	15/05	08:00	18:00	AM	15/05
14	15/05	08:00	18:00	PM	15/05
15	15/05	08:00	18:00	AM	15/05
16	15/05	08:00	18:00	PM	15/05

Order No.	Date	Start	End	By	Approved
17	15/05	08:00	18:00	AM	15/05
18	15/05	08:00	18:00	PM	15/05
19	15/05	08:00	18:00	AM	15/05
20	15/05	08:00	18:00	PM	15/05